

#### ADDENDUM NO. 04

Project Name: Pe Ell K-12 School Modernization

**Aetta Project #**: 24014 **Date**: 8/21/25

#### **NOTICE TO BIDDERS:**

The amendments and additions provided in this addendum shall become part of the Contract Documents for this Project. Bidder shall acknowledge receipt of this, and all other Addendum in the space provided on the **Bid Form**.

#### BIDS DUE DATE IS REVISED AS INDICATED BELOW:

#### **GENERAL INFORMATION / CLARIFICATION:**

Item # Location/Section: Description

4.1.0

#### **DRAWINGS:**

Architectural

Item #: Sheet: Description:

4.2.0 A235, A236, REPLACE sheets as indicated in Addendum No.2 with attached revised

A301, A302, drawings.

A401, A402

#### SPECIFICATIONS:

Item #Section:Description4.9.000 41 00REPLACE entire section with attached revised section; removing list of<br/>Allowances defined elsewhere (cost to be included in Base Bid Amount)

00 21 14 1.01. F. **ADD** "Base Bid amount shall include allowances listed."

1.01 ADD in its entirety, "O. An "Allowance" is a designated amount listed in the Bidding Documents or in the Contract Documents stating cost to be included in the total Base Bid amount for specific project scope."

Scope

01 21 00
ALLOWANCES
1.03, C. **REVISE** to read: "C. Allowances listed shall be included in the total base bid amount. At closeout of Contract, funds remaining in Contingency Allowance will be credited to Owner by Change Order."


#### **SUBSTITUTIONS:**

Section #: Item: Approved Product: Manufacturer

#### **Attachments:**

Revised Drawing Sheets A235, A236, A301, A302, A401, A402 Revised Specification Sections

#### **END OF ADDENDUM NO. 04**

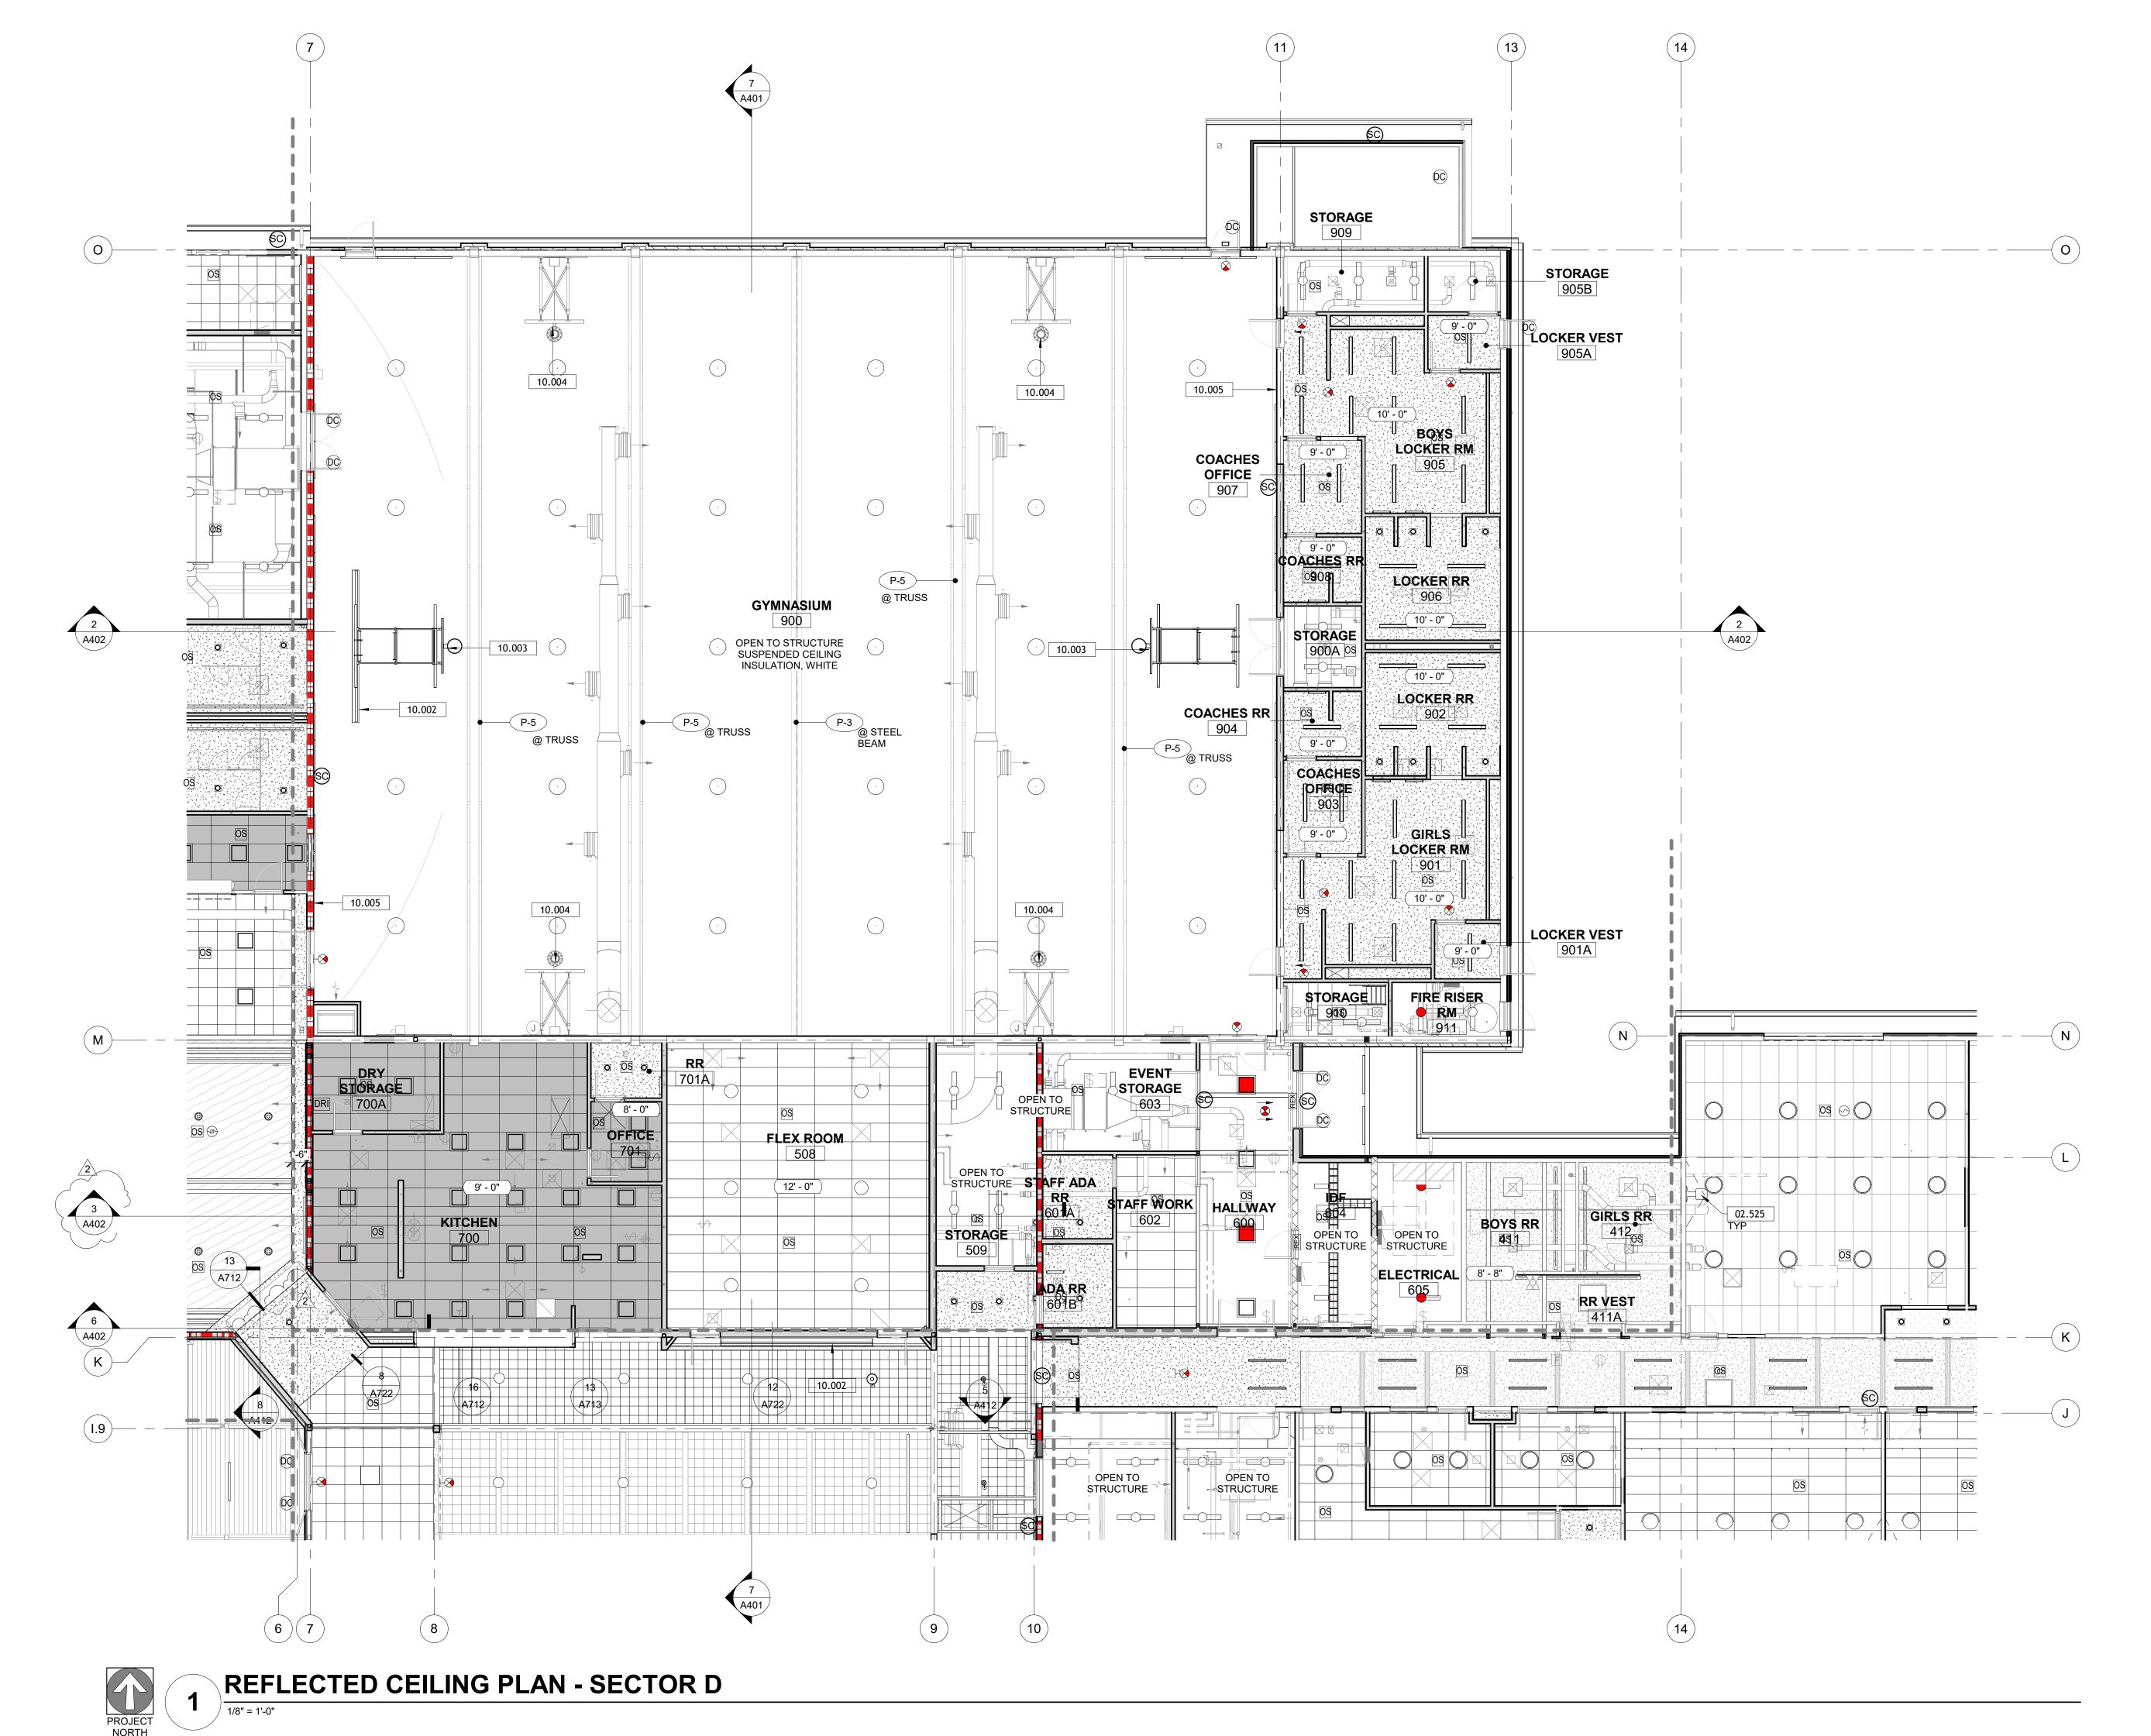


## REFLECTED CEILING GENERAL NOTES:

- REFER TO CODE ANALYSIS SHEETS FOR RATED CONSTRUCTION AND OPENING
  PROTECTION
- 2. CEILING ELEVATIONS INDICATE THE HEIGHT ABOVE THE FINISHED FLOOR IN THE ROOM OR AREA IN WHICH THE CEILING IS LOCATED.
- OR AREA IN WHICH THE CEILING IS LOCATED.
- ACOUSTICAL CEILING GRID SHALL BE PROVIDED PER THE NORTHWEST WALL AND CEILING BUREAU TECHNICAL FEILD MANUAL 401 SEISMIC ZONE D.
- 4. REFER TO MECHANICAL DRAWINGS FOR LOCATIONS OF GRILLS, REGISTERS, DIFFUSERS, AND ALL OTHER ELECTRICAL EQUIPMEN. DEVICES INDICATED ON THE DOCUMENT ARE FOR COORDINATEION PURPOSES. CENTER ALL MECHANICAL, SPRINKLER, AND ELECTRICAL ITEMS IN 2X2 PORTION OF CEILING TILES, AS APPLICABLE.
- 5. IN ROOMS AND AREAS WHERE FLOOR & ROOF STRUCTURE ABOVE IS EXPOSED, CLEAN AND PREP DUCTWORK, CONDUIT, AND PIPING FOR PAINT TO MATCH ADJACENT PAINTED EXPOSED MATERIALS.
- 6. APPROVED FIRE SPRINKLER SYSTEMS TO EXTEND THROUGHOUT THE ENTIRE STRUCTURE AND IS TO INCLUDE EXTERIOR COVERED AREAS AS REQUIRED.
- SPRINKLER HEADS LOCATED IN GYPSUM BOARD CEILINGS SHALL BE FULLY RECESSED AND FACTORY PAINTED TO MATCH CEILING. DISTRIBUTION OF HEADS MUST MEET GOVERNING CODES.
- 8. SUBMIT SPRINKLER LAYOUTS TO ARCHITECT AND OWNER FOR APPROVAL PRIOR TO INSTALLATION
- 9. ALL STROBES TO BE WHITE OR MATCH EXISTING BUILDING STANDARD AND BE LOCATED IN CEILING WHERE ALLOWABLE BY CODE. FINAL LOCATION TO BE APPROVED BY ARCHITECT AND OWNER
- ALL SWITCHES TO BE MOUNTED WITH 6 INCHES MINIMUM DIMENSION FROM FRAME, OR OTHERWISE NOTED UNO.
- 11. DAYLIGHT AND OCCUPANCY SENSORS TO BE LOCATED BY DESIGN BUILD ELECTRICAL AND APPROVED BY ARCHITECT AND OWNER.

# WSEC LIGHTING NOTES: 1 PROVIDE LIGHTING CONTROLS PER WSEC CA

1. PROVIDE LIGHTING CONTROLS PER WSEC C405.2.1 - C405.2.8

## LEGEND:

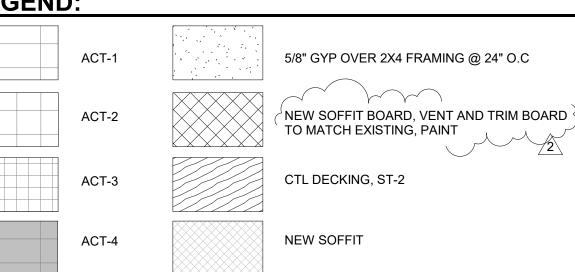

## **KEYNOTE LEGEND**

•	
02.525	PROJECTOR, INSTALL PER MFR ALIGNMENT
	RECOMMENDATIONS
10.002	10'x 16' MOTORIZED PROJECTION SCREEN
10.003	NEW SUSPENDED BASKETBALL HOOP & BACKSTOP
10.004	NEW WALL MOUNTED BASKETBALL HOOP & BACKSTO
10.005	NEW SCORE BOARD

PROJECT # 24014
DATE 07/15/25

DISTRICT

SCHOOL

PE

Architects

950 12th Avenue Suite 200

Longview, WA 98632 PH: 360-425-0000


www.aetta.com

REVISIONS

NO. DATE DESCRIPTION
2 8/7/25 ADDENDUM NO.2

REFLECTED CEILING PLAN - SECTOR D

A235

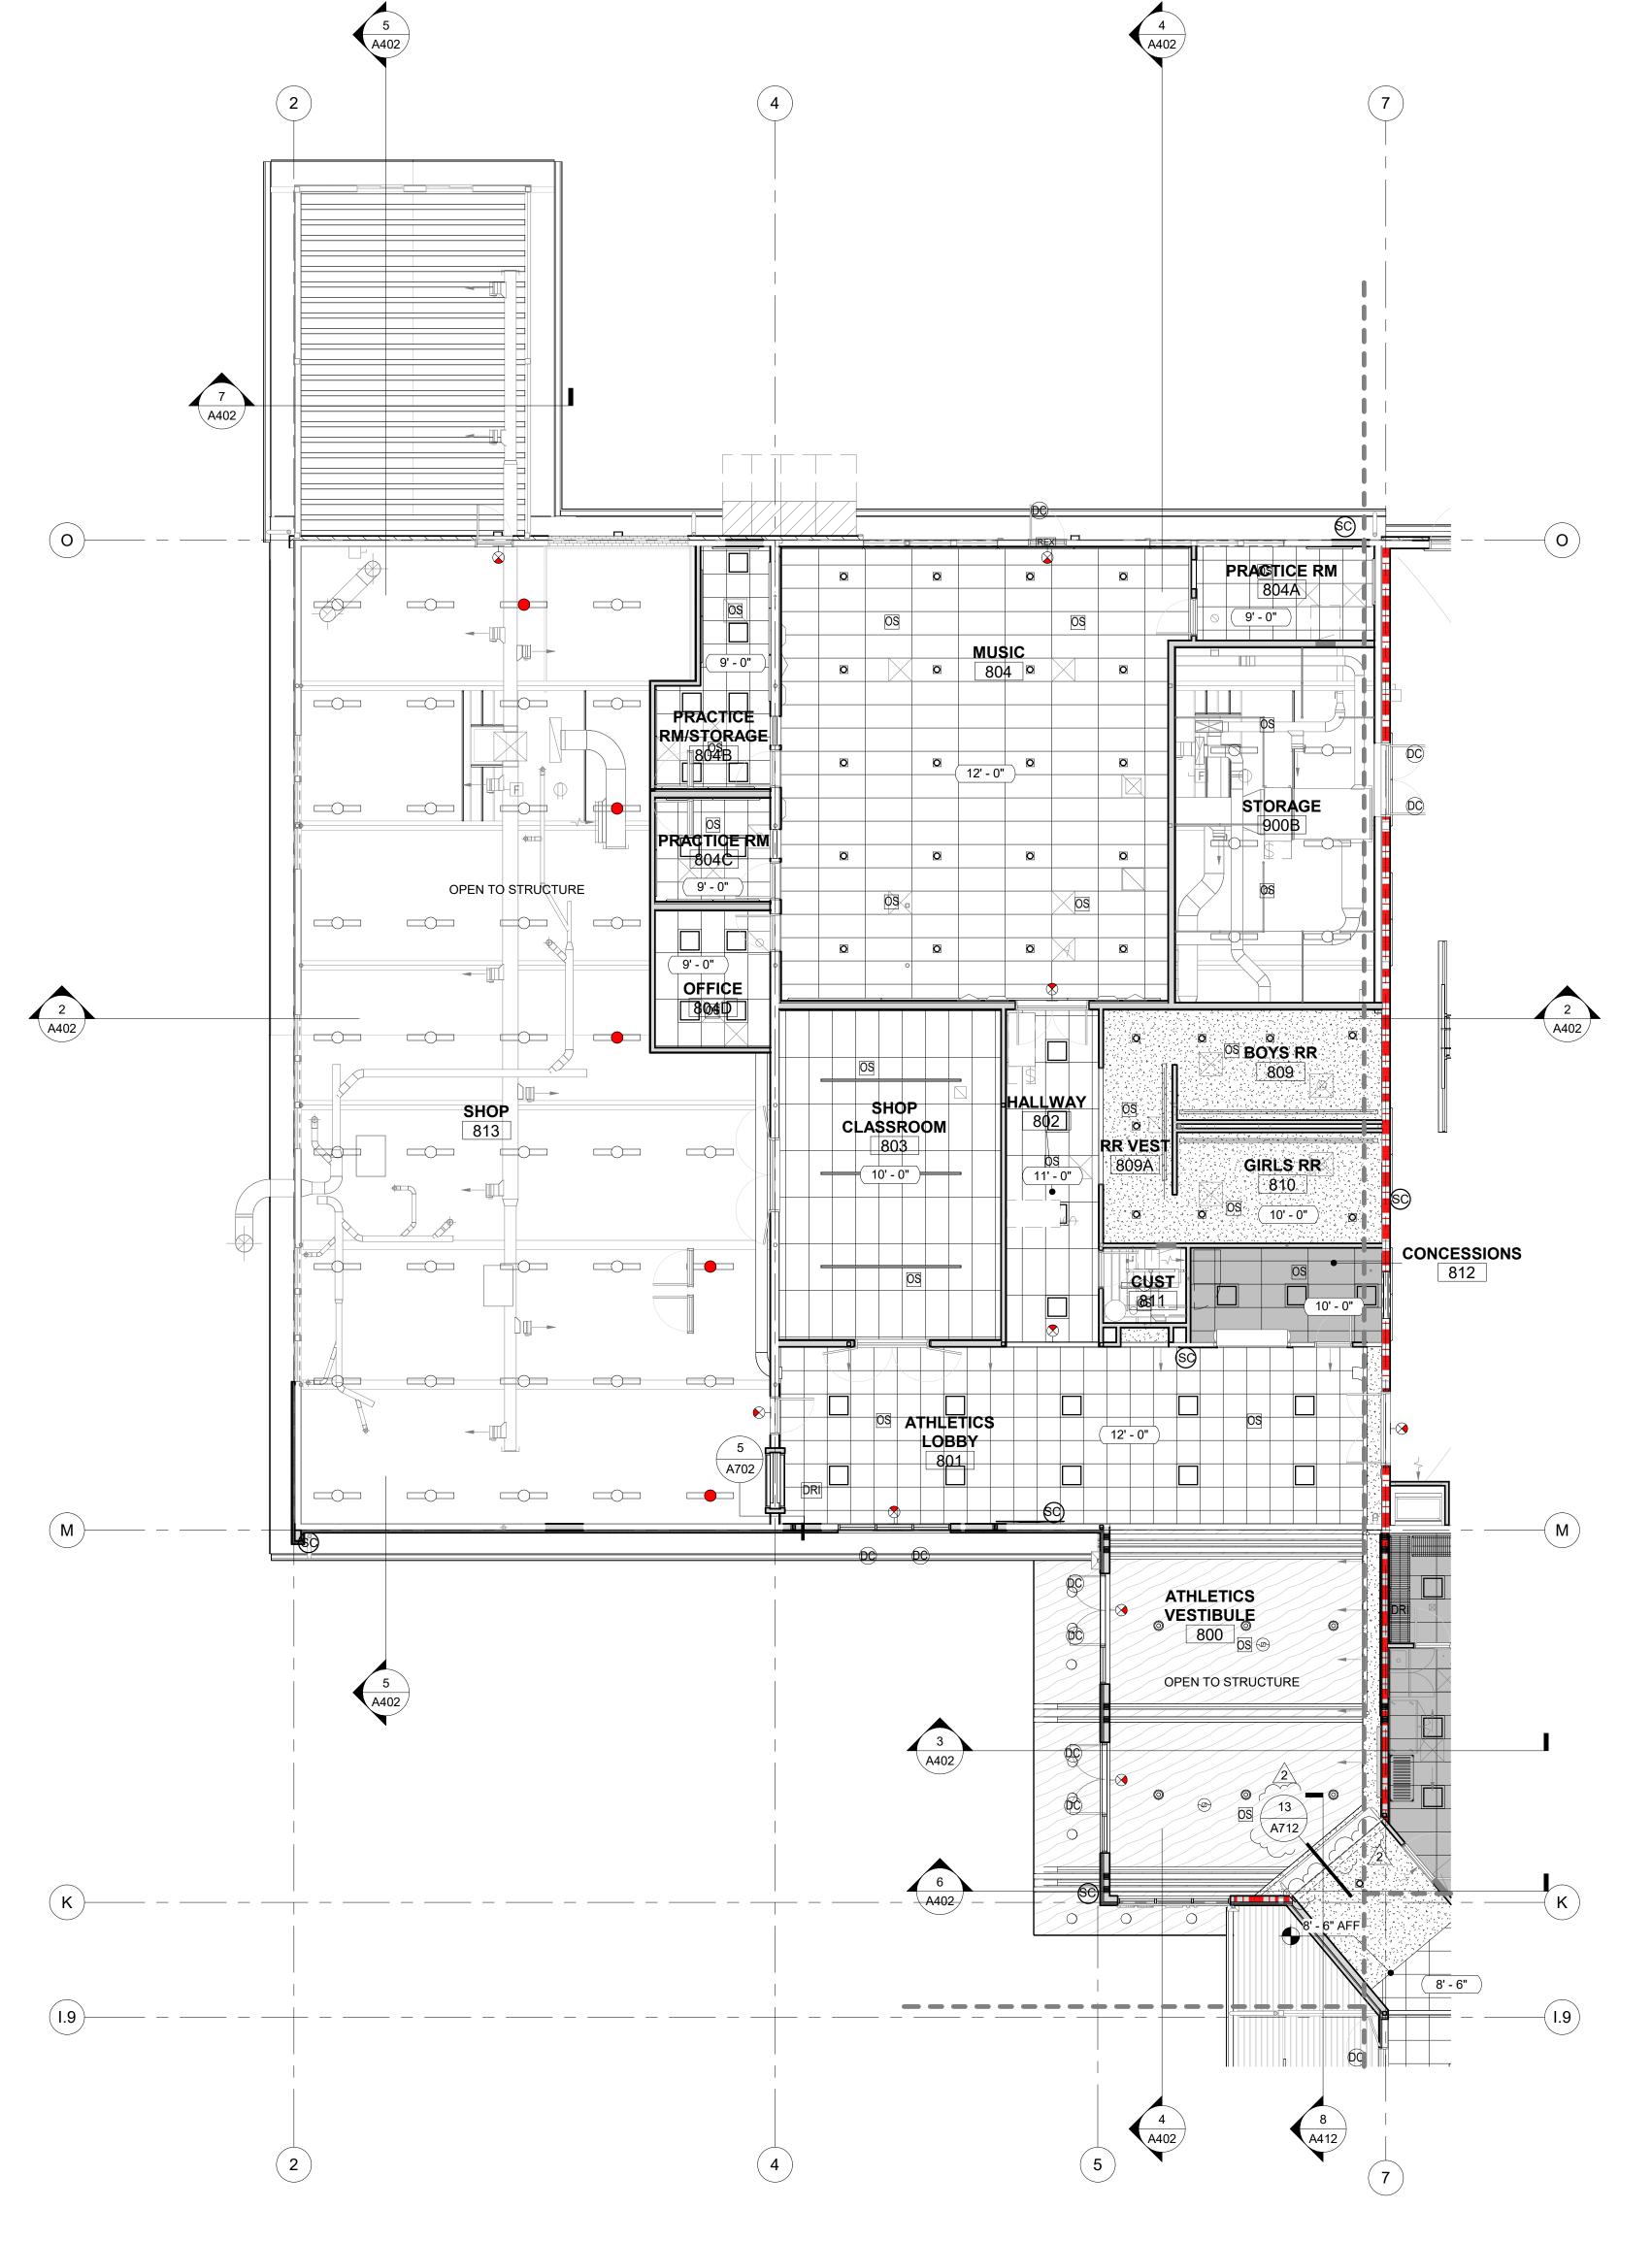




## REFLECTED CEILING GENERAL NOTES:

- REFER TO CODE ANALYSIS SHEETS FOR RATED CONSTRUCTION AND OPENING
- CEILING ELEVATIONS INDICATE THE HEIGHT ABOVE THE FINISHED FLOOR IN THE ROOM OR AREA IN WHICH THE CEILING IS LOCATED.
- 3. ACOUSTICAL CEILING GRID SHALL BE PROVIDED PER THE NORTHWEST WALL AND CEILING BUREAU TECHNICAL FEILD MANUAL 401 SEISMIC ZONE D.
- 4. REFER TO MECHANICAL DRAWINGS FOR LOCATIONS OF GRILLS, REGISTERS, DIFFUSERS, AND ALL OTHER ELECTRICAL EQUIPMEN. DEVICES INDICATED ON THE DOCUMENT ARE FOR COORDINATEION PURPOSES. CENTER ALL MECHANICAL, SPRINKLER, AND ELECTRICAL ITEMS IN 2X2 PORTION OF CEILING TILES, AS APPLICABLE.
- IN ROOMS AND AREAS WHERE FLOOR & ROOF STRUCTURE ABOVE IS EXPOSED, CLEAN AND PREP DUCTWORK, CONDUIT, AND PIPING FOR PAINT TO MATCH ADJACENT PAINTED EXPOSED MATERIALS.
- 6. APPROVED FIRE SPRINKLER SYSTEMS TO EXTEND THROUGHOUT THE ENTIRE STRUCTURE AND IS TO INCLUDE EXTERIOR COVERED AREAS AS REQUIRED.
- 7. SPRINKLER HEADS LOCATED IN GYPSUM BOARD CEILINGS SHALL BE FULLY RECESSED AND FACTORY PAINTED TO MATCH CEILING. DISTRIBUTION OF HEADS MUST MEET GOVERNING CODES.
- 8. SUBMIT SPRINKLER LAYOUTS TO ARCHITECT AND OWNER FOR APPROVAL PRIOR TO INSTALLATION
- ALL STROBES TO BE WHITE OR MATCH EXISTING BUILDING STANDARD AND BE LOCATED IN CEILING WHERE ALLOWABLE BY CODE. FINAL LOCATION TO BE APPROVED BY ARCHITECT AND OWNER
- 10. ALL SWITCHES TO BE MOUNTED WITH 6 INCHES MINIMUM DIMENSION FROM FRAME, OR OTHERWISE NOTED UNO.
- 11. DAYLIGHT AND OCCUPANCY SENSORS TO BE LOCATED BY DESIGN BUILD ELECTRICAL AND APPROVED BY ARCHITECT AND OWNER.

## **WSEC LIGHTING NOTES:**

1. PROVIDE LIGHTING CONTROLS PER WSEC C405.2.1 - C405.2.8

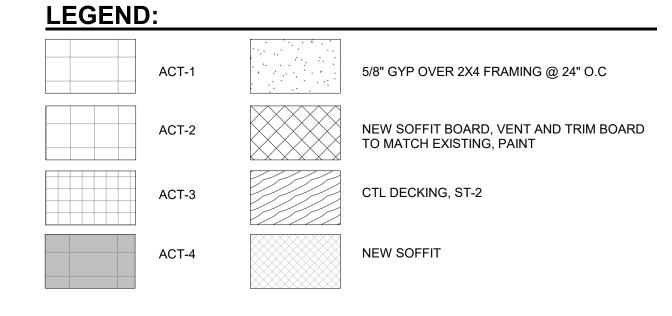

## **KEYNOTE LEGEND**



950 12th Avenue Suite 200 Longview, WA 98632 PH: 360-425-0000 www.aetta.com

PE ELL SCHOOL DISTRICT L K-12 SCHOOL MODERNIZATION

PROJECT # 2401


DATE 07/15/2

REVISIONS


NO. DATE DESCRIPTION
2 8/7/25 ADDENDUM NO.2

REFLECTED CEILING PLAN - SECTOR E

**A236** 

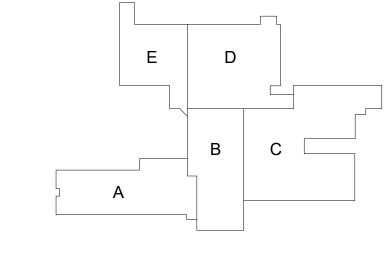




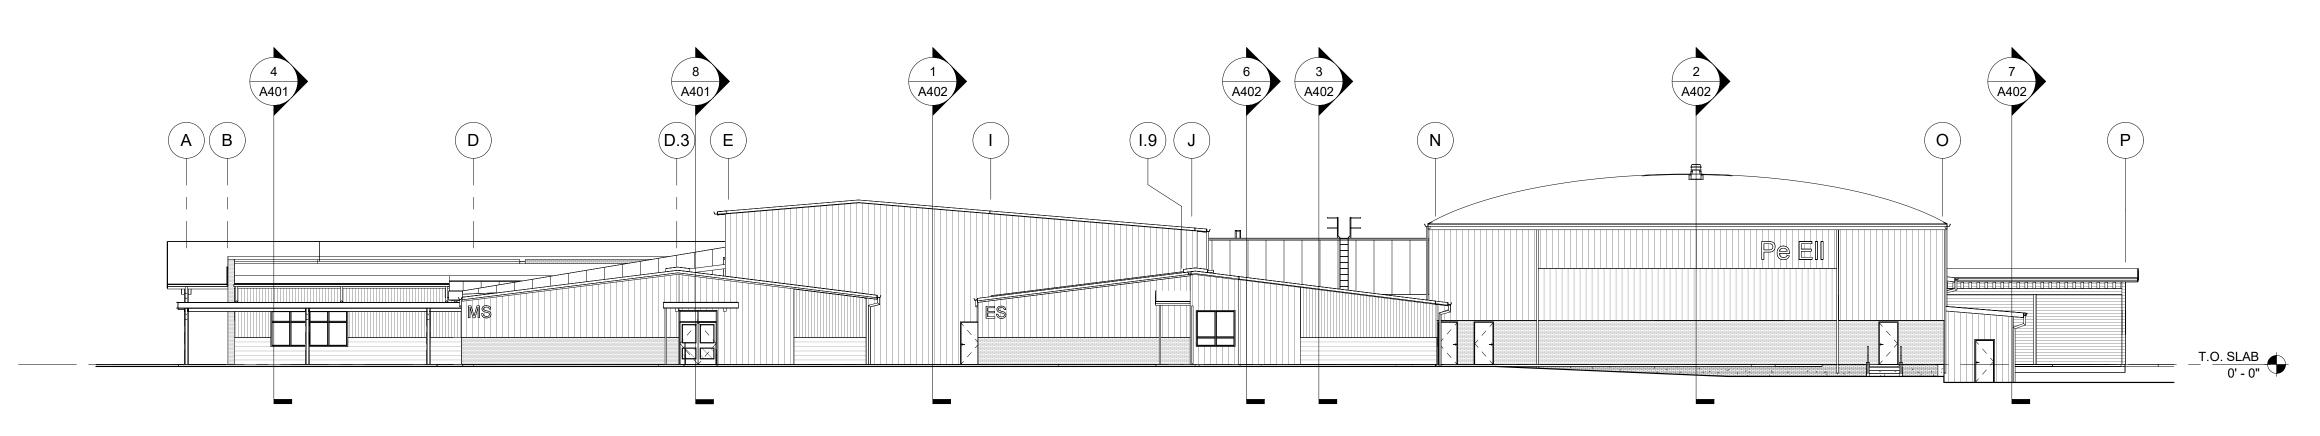


2 EAST ELEVATION - OVERALL

1/16" = 1'-0"

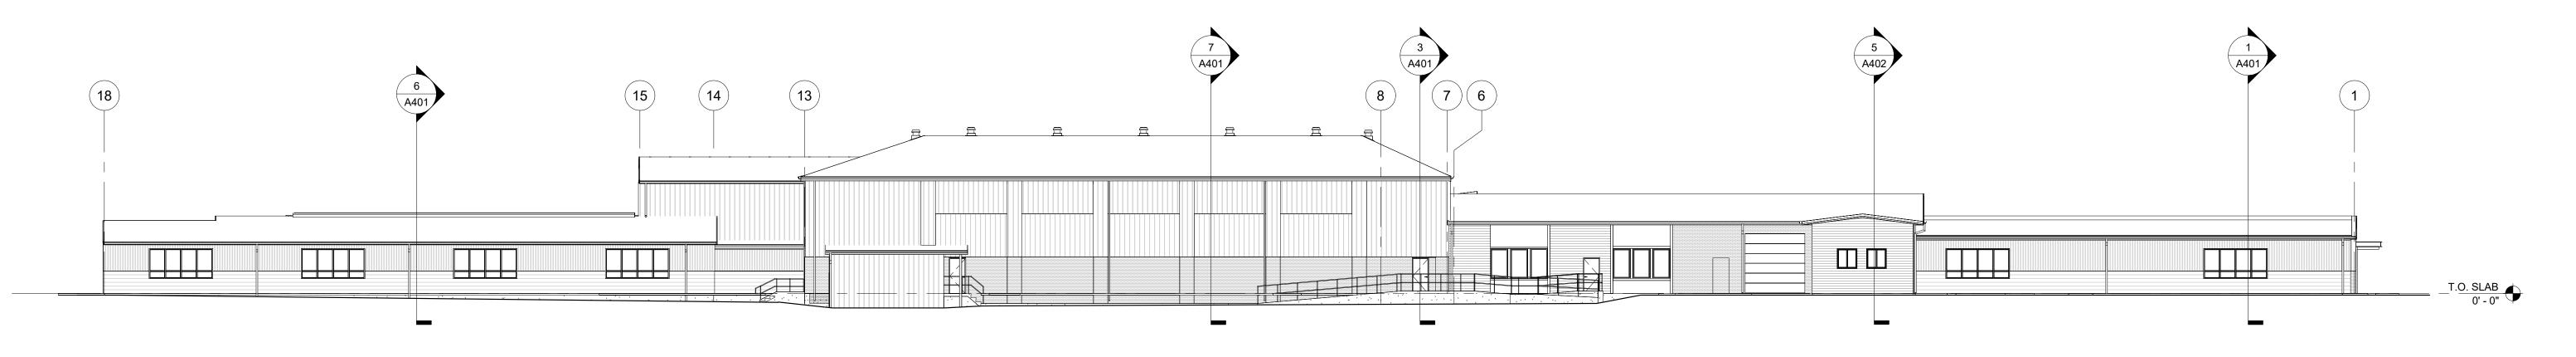

# NORTH ELEVATION - OVERALL 1/16" = 1'-0"

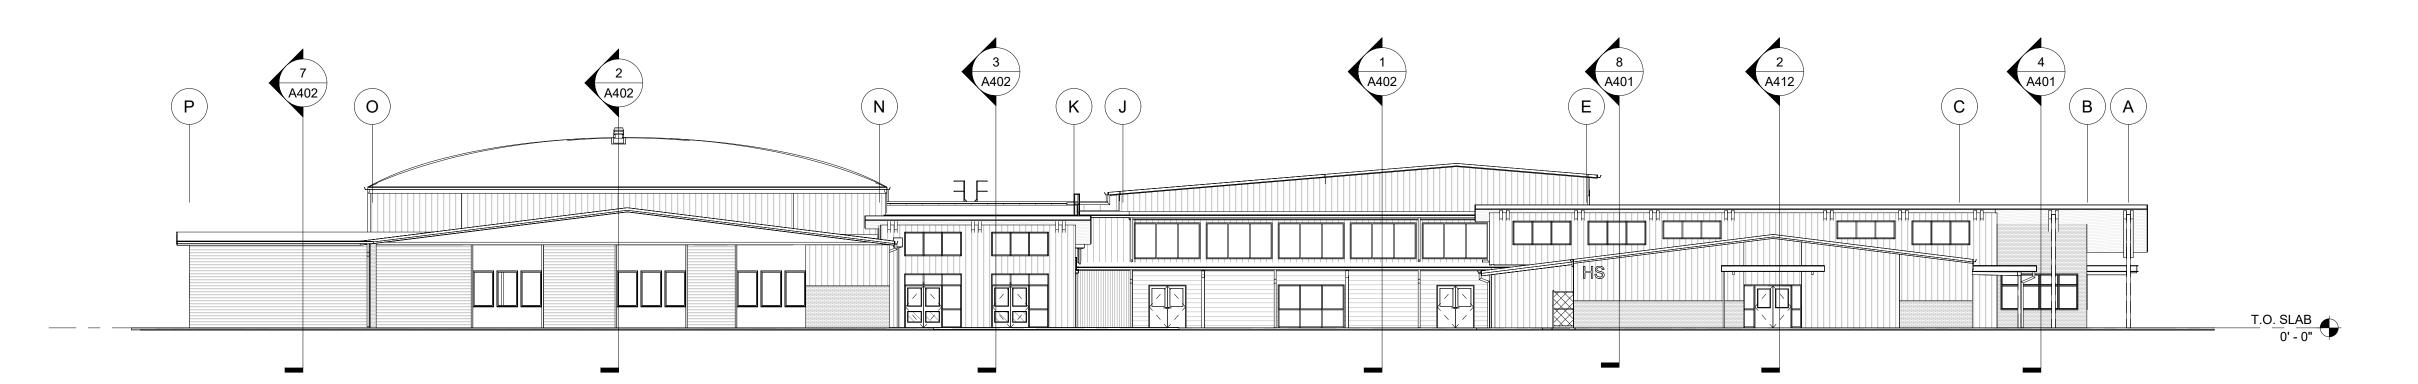

4 WEST ELEVATION - OVERALL

1/16" = 1'-0"

aetta.
Architects

950 12th Avenue Suite 200 Longview, WA 98632 PH: 360-425-0000 www.aetta.com


DISTRICT SCHOOL PE

REVISIONS

NO. DATE DESCRIPTION
2 8/7/25 ADDENDUM NO.2

EXTERIOR ELEVATIONS -OVERALL

**A301** 

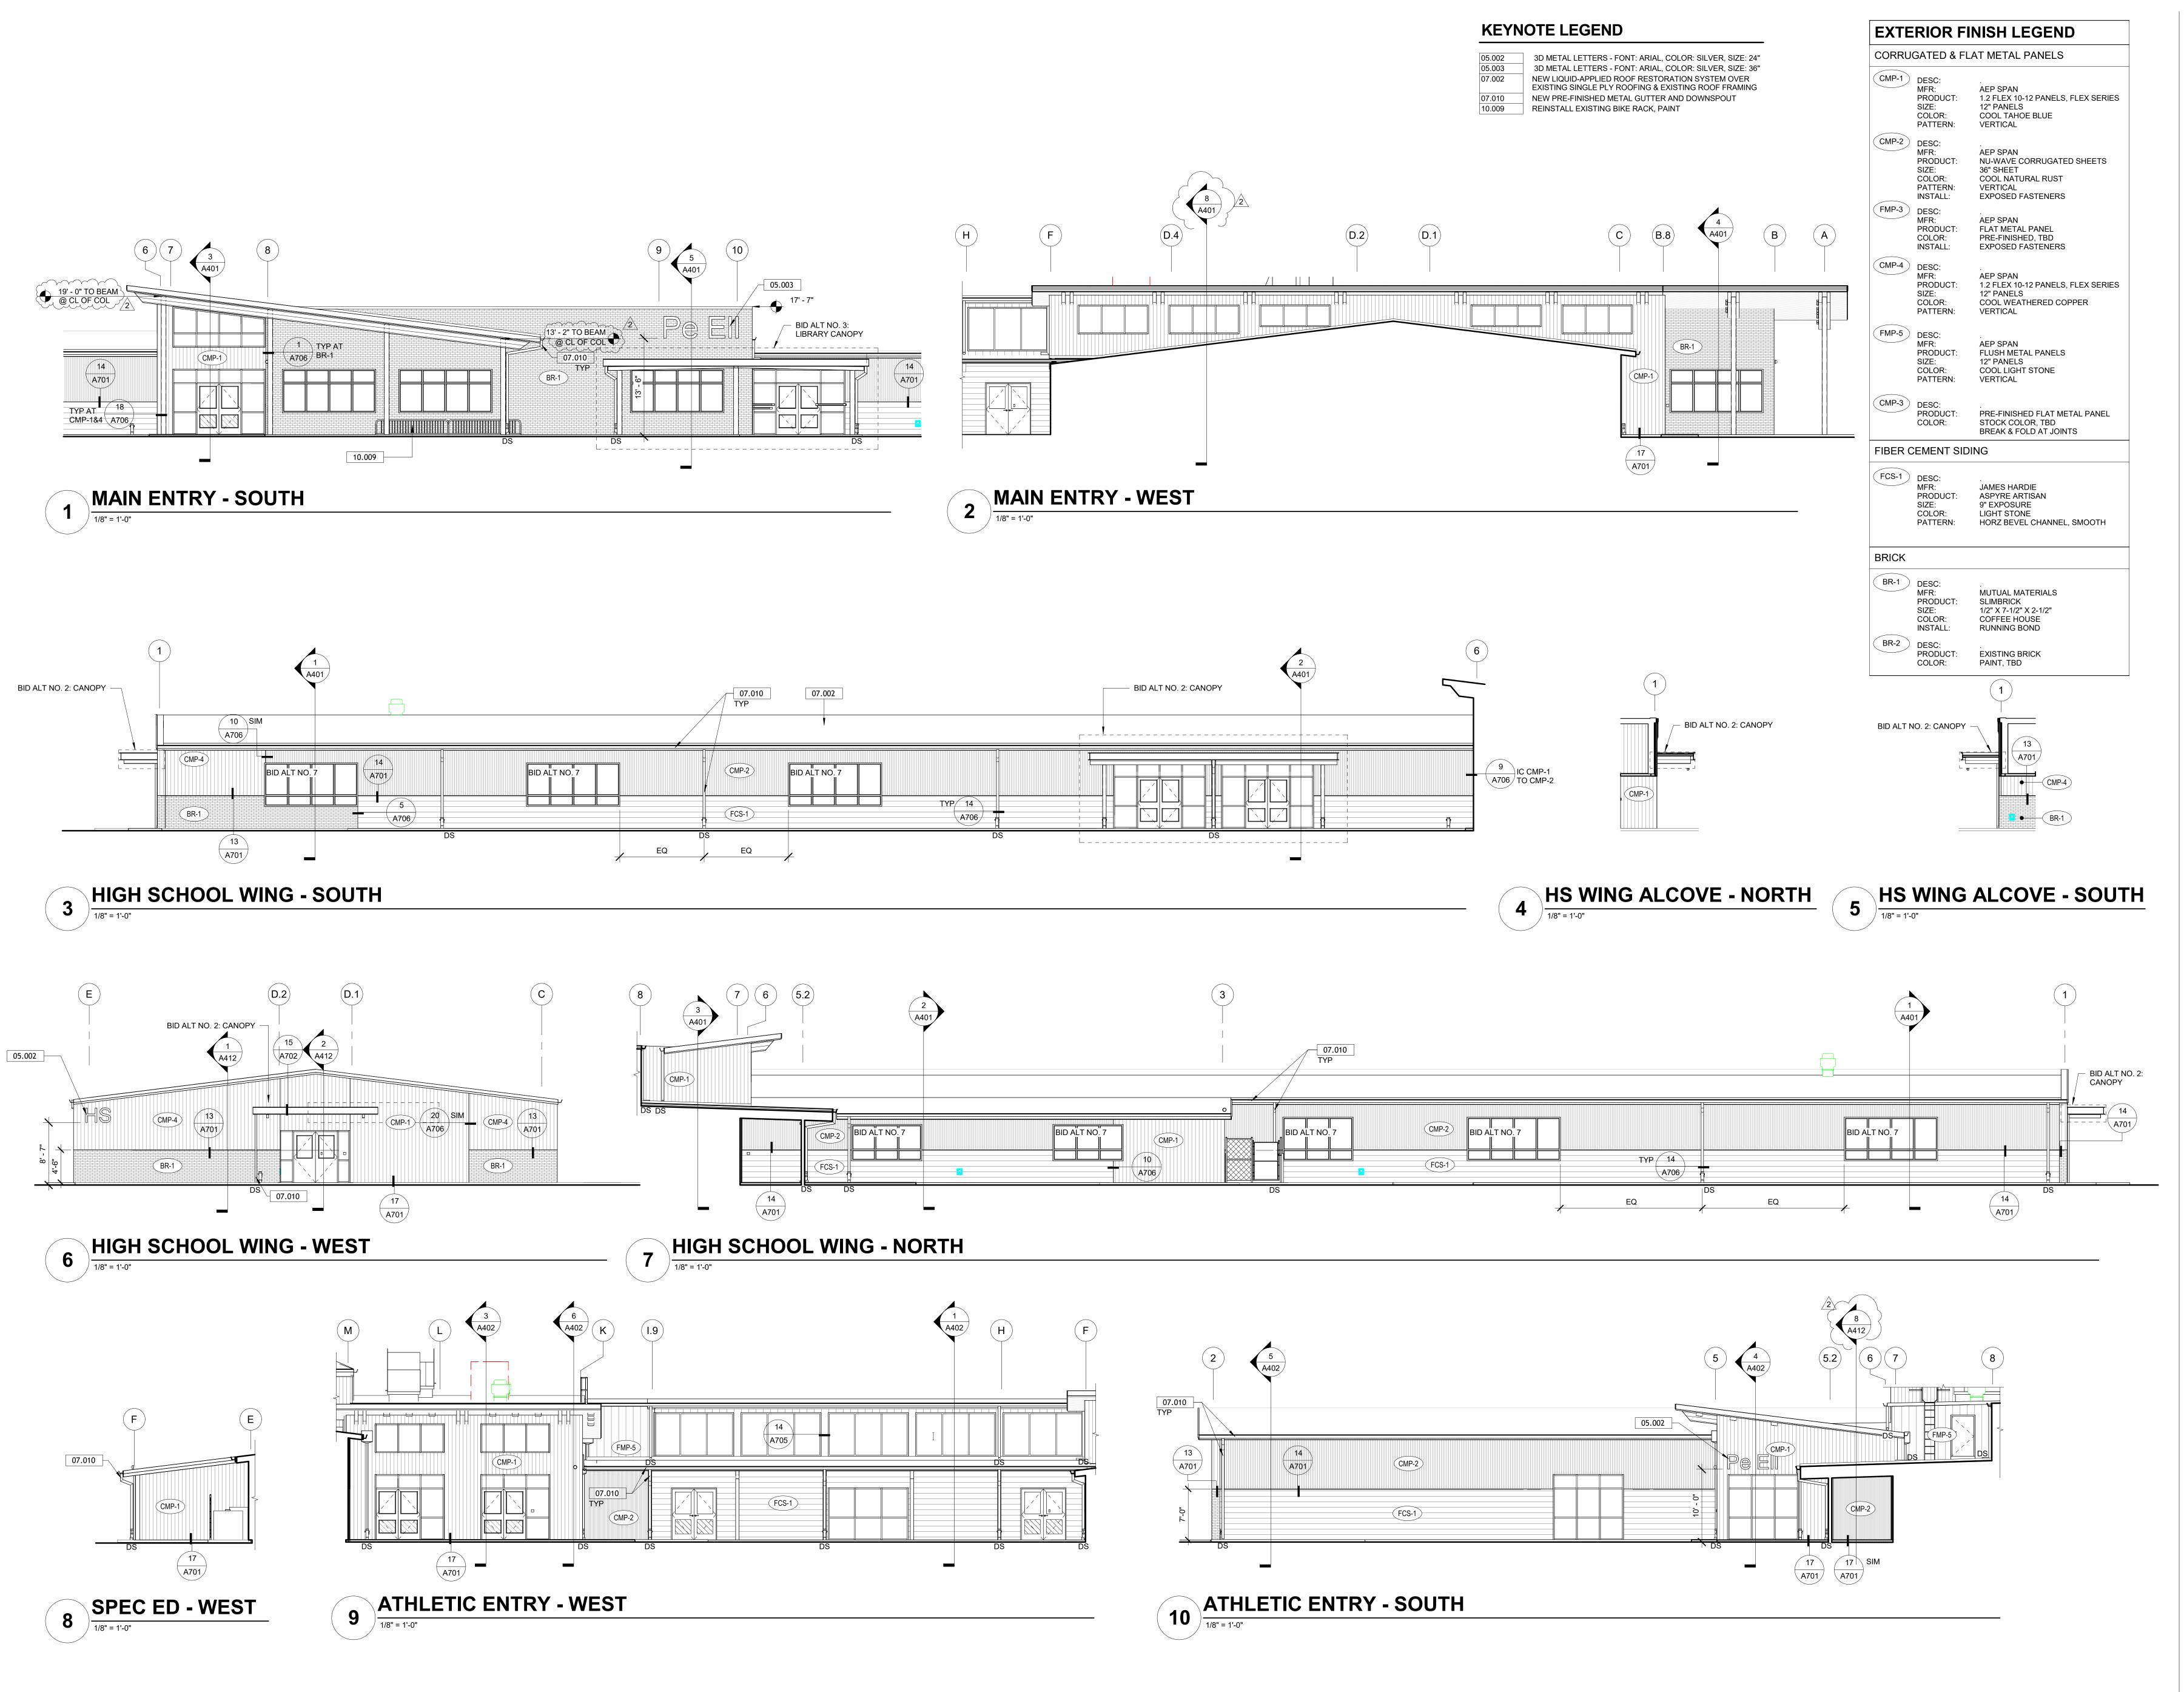

aetta.
Architects

950 12th Avenue Suite 200 Longview, WA 98632 PH: 360-425-0000 www.aetta.com

PE ELL SCHOOL DISTRICT ELL K-12 SCHOOL MODERNIZATIO

PROJECT # 24014


DATE 07/15/25

REVISIONS

NO. DATE DESCRIPTION
2 8/7/25 ADDENDUM NO.2

ENLARGED EXTERIOR ELEVATIONS

A302

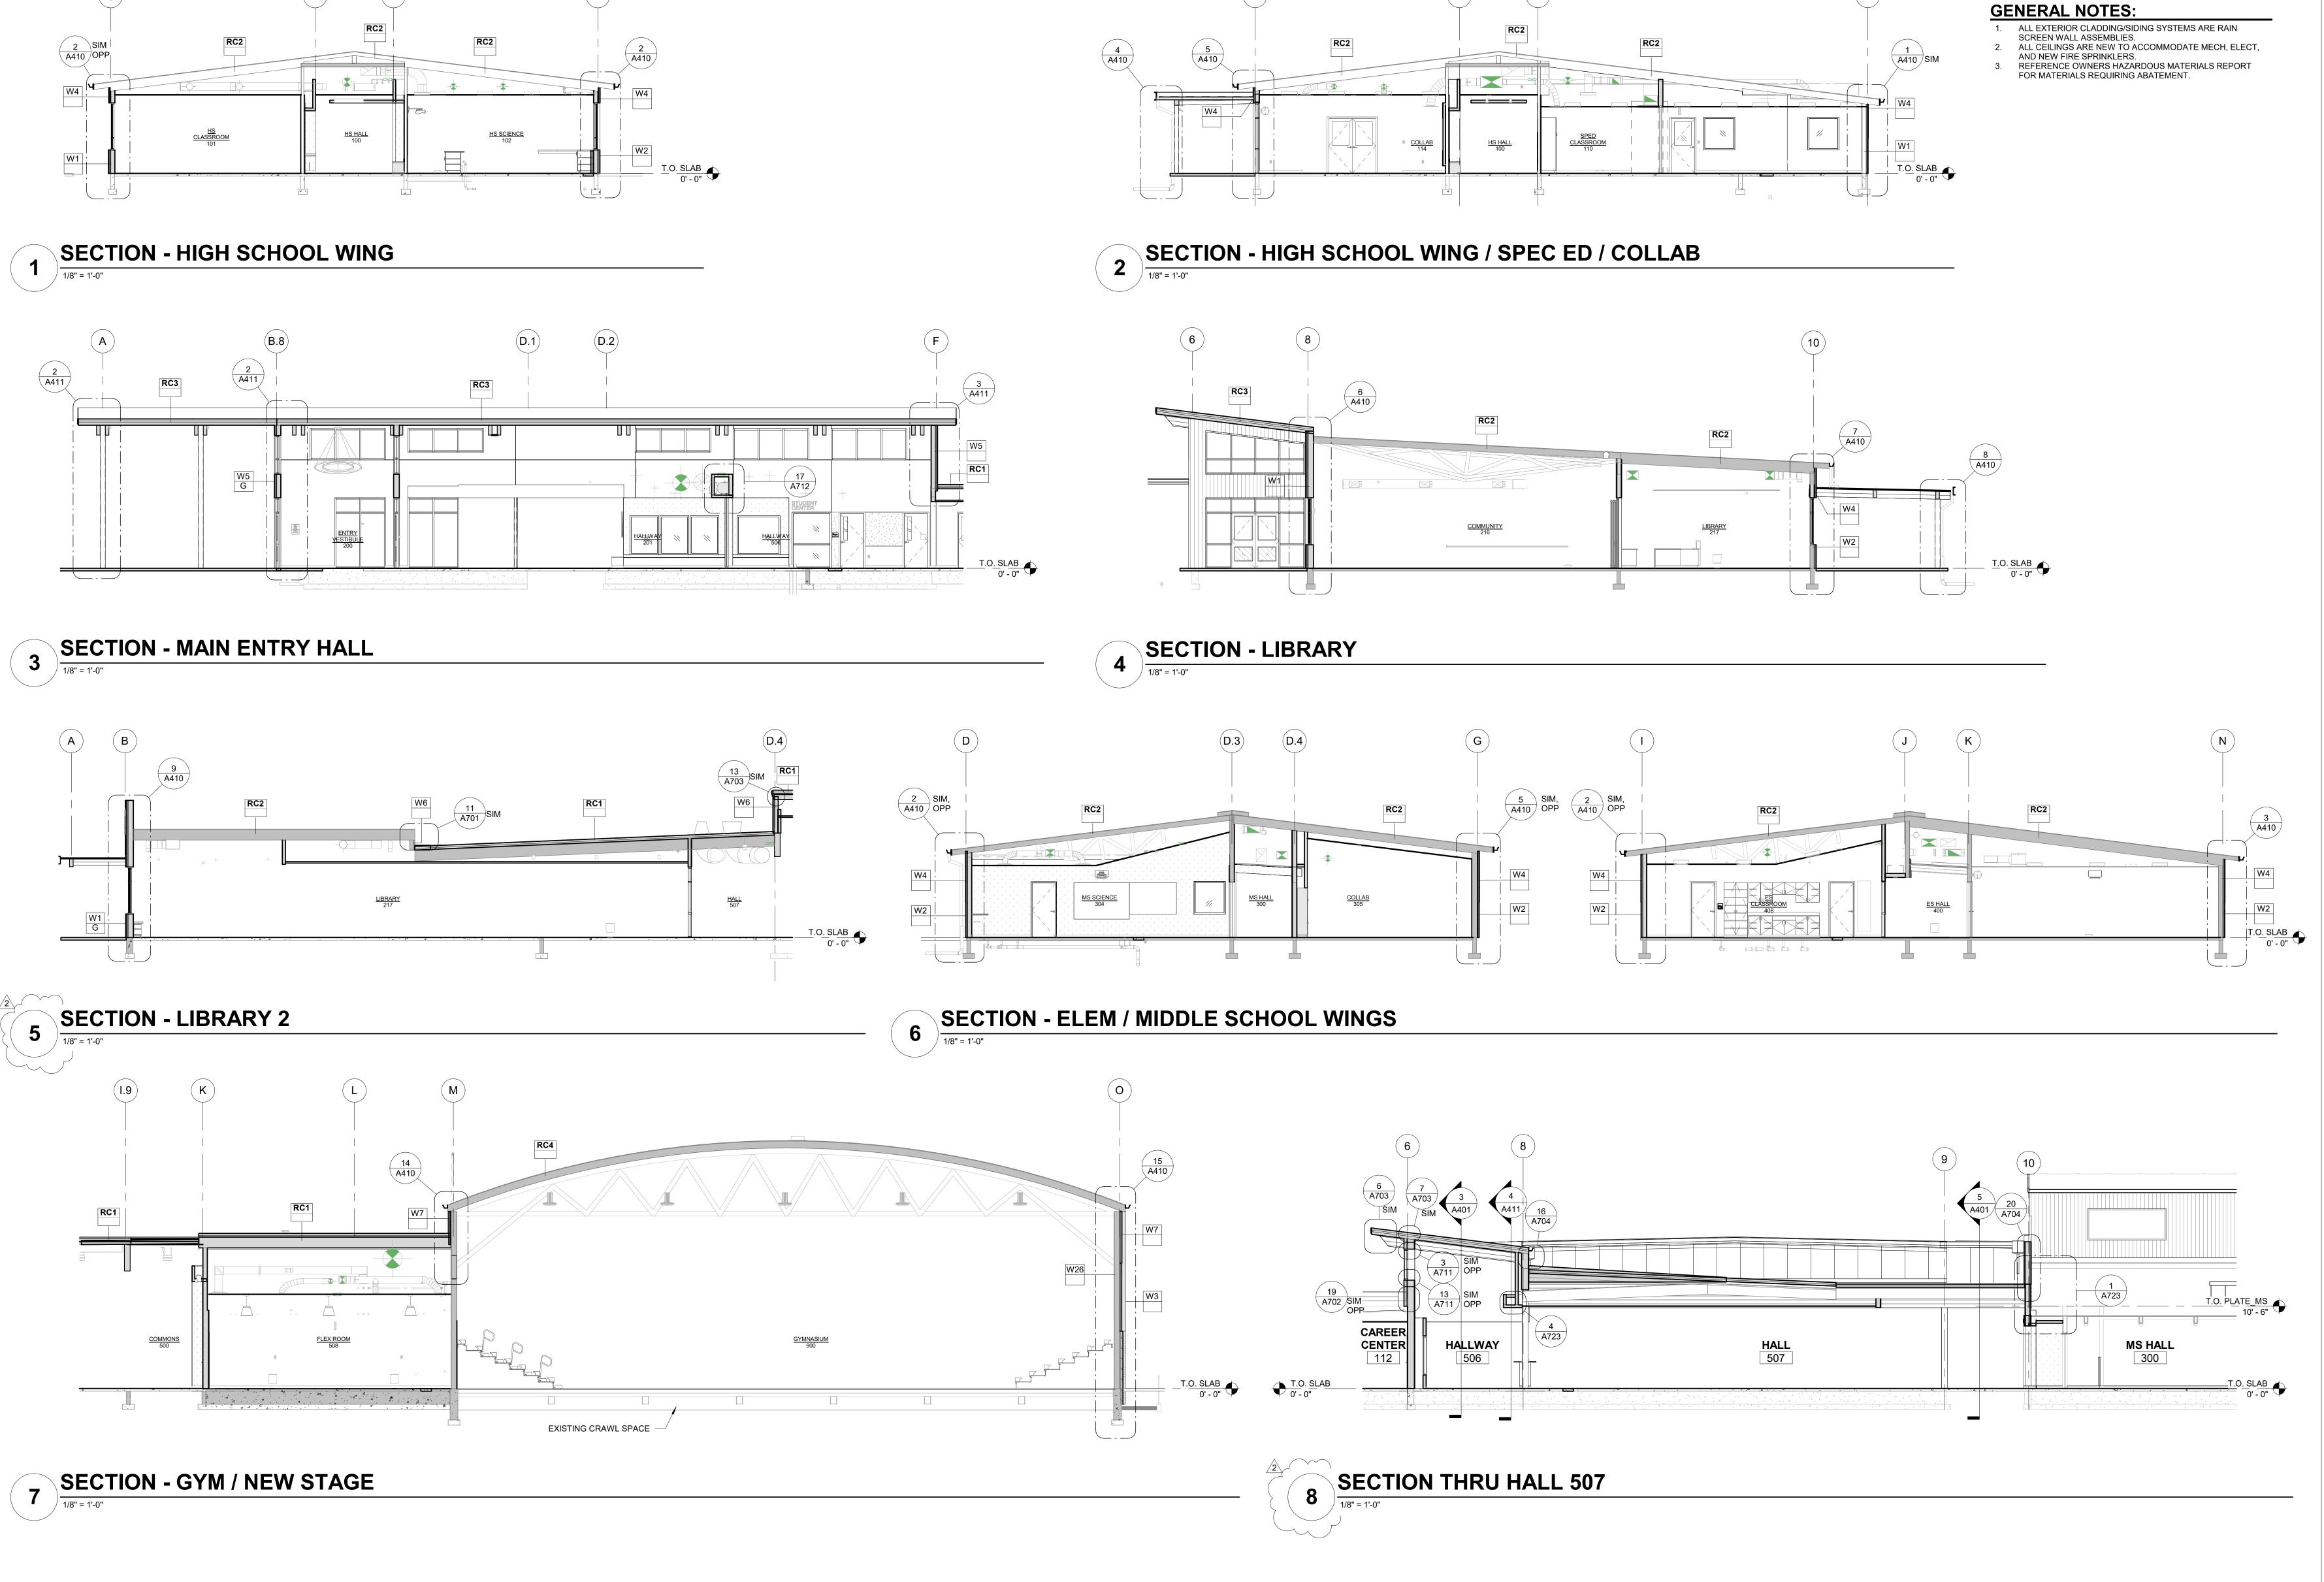

aetta.
Architects

950 12th Avenue Suite 200 Longview, WA 98632 PH: 360-425-0000 www.aetta.com

PH: 360-425-0000 www.aetta.com

SCHOOL DISTRICT CHOOL MODERNIZATION

PROJECT # 2401
DATE 07/15/2

REVISIONS

NO. DATE DESCRIPTION
2 8/7/25 ADDENDUM NO.2

BUILDING SECTIONS

A401

5 SECTION - SHOP

1/8" = 1'-0"

## **GENERAL NOTES:**

SECTION AT SHOP STORAGE

 $7 \frac{310}{1/8" = 1'-0"}$ 

- ALL EXTERIOR CLADDING/SIDING SYSTEMS ARE RAIN SCREEN WALL ASSEMBLIES.
   ALL CEILINGS ARE NEW TO ACCOMMODATE MECH, ELECT,
- AND NEW FIRE SPRINKLERS.

  3. REFERENCE OWNERS HAZARDOUS MATERIALS REPORT FOR MATERIALS REQUIRING ABATEMENT.

aetta.
Architects

950 12th Avenue Suite 200 Longview, WA 98632 PH: 360-425-0000 www.aetta.com

DISTRICT SCHOOL


PROJECT# REVISIONS

NO. DATE DESCRIPTION
2 8/7/25 ADDENDUM NO.2

BUILDING SECTIONS

A402

BID SET

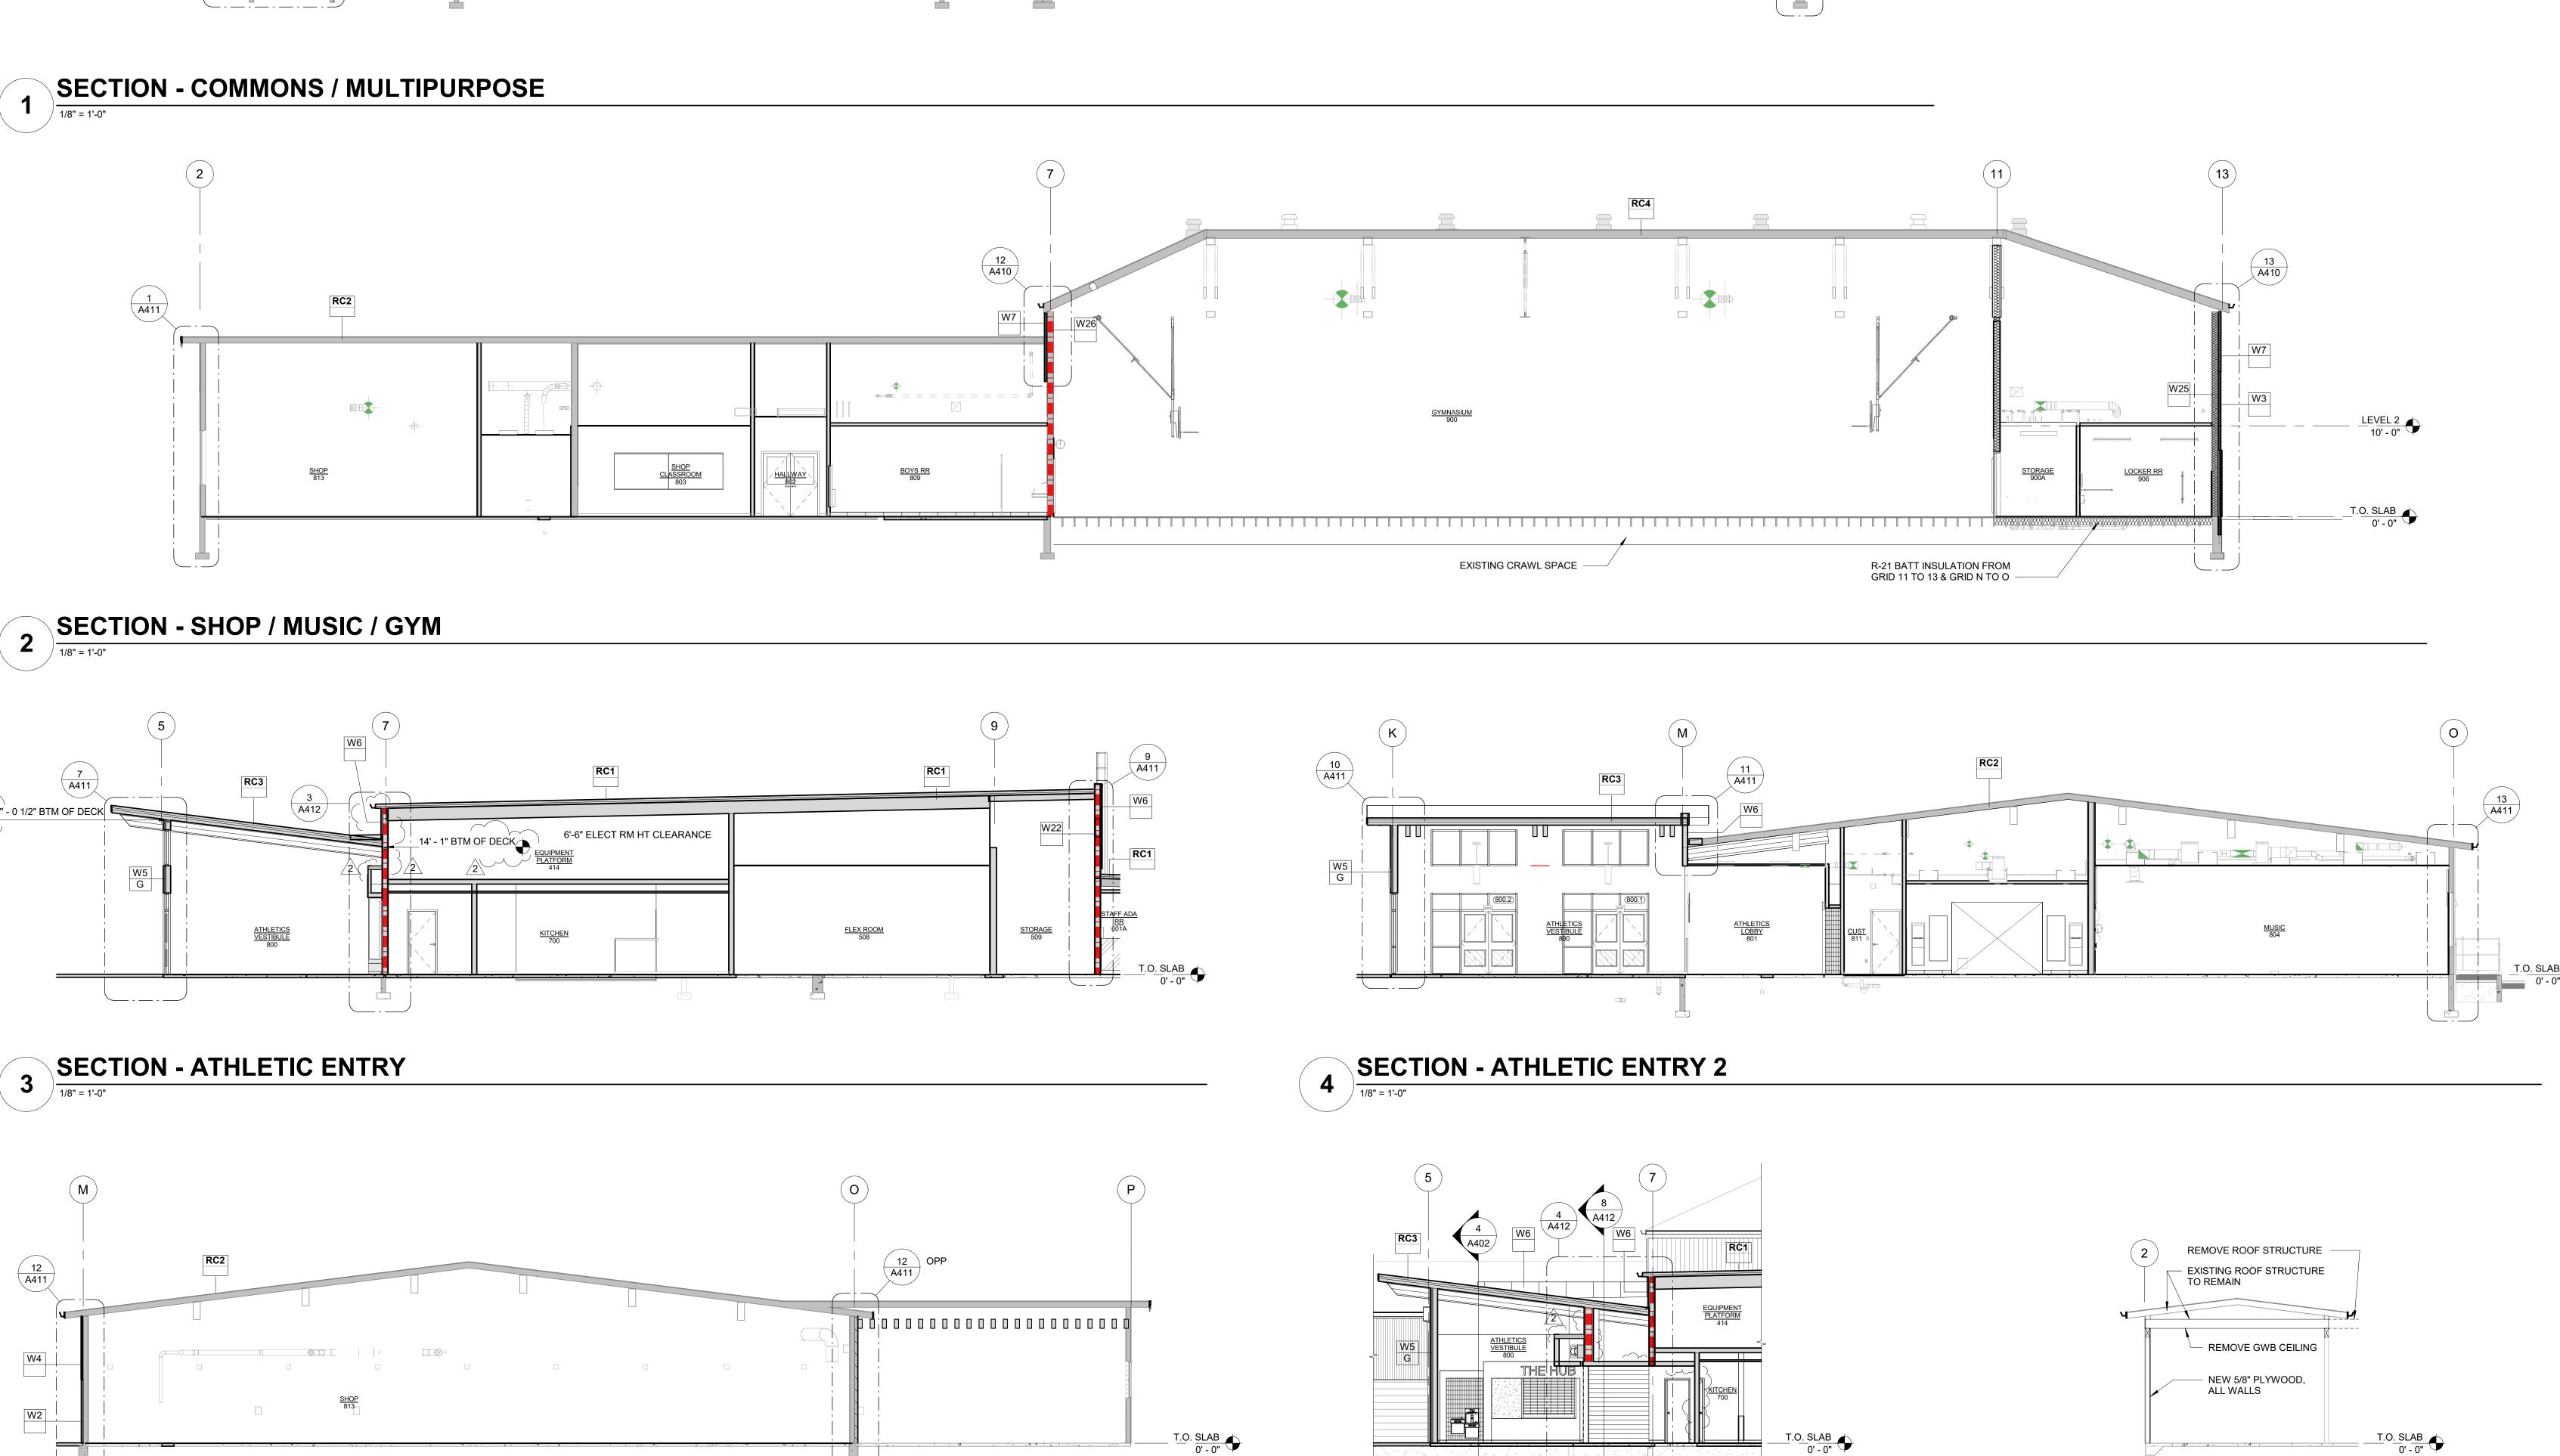

6 SECTION AT ATHLETICS VEST HALL

1/8" = 1'-0"

#### SECTION 00 41 00 BID FORM

#### **PROJECT**

Pe Ell School Modernization Project Pe Ell School District No. 301 519 N. 2<sup>nd</sup> Street, Pe Ell, WA 98572

#### **SUBMISSIONS:**

#### **BASE BID:**

By: 2:00 p.m. (PDT), Wednesday, August 27, 2025

#### **ALTERNATES & UNIT COSTS:**

By: 2:00 p.m. (PDT), Wednesday, August 27, 2025

#### SUBCONTRACTOR LIST FOR PLUMBING, HVAC, AND ELECTRICAL:

By: 2:00 p.m. (PDT), Wednesday, August 27, 2025

#### SUBCONTRACTOR LIST FOR STRUCTURAL STEEL AND REBAR INSTALLERS:

By: 2:00 p.m. (PDT), Friday, August 29, 2025

TO:

**Board of Directors** 

Pe Ell School District No. 301

519 N. 2<sup>nd</sup> Street

Pe Ell, WA 98572

#### BID OPENING - BASE BIDS, ALTERNATES / UNIT COSTS AND SUBCONTRACTOR LIST

At: 2:05 p.m. (PDT), Wednesday, August 27, 2025.

LOCATION:

Pe Ell School District No. 301

519 N. 2nd Street

Pe Ell, WA 98572

FROM:	:	

### (GENERAL CONTRACTOR NAME)

#### TO: BOARD OF DIRECTORS

The undersigned proposes to furnish materials and labor and to perform all Work for the above-described project in strict accordance with the drawings, specifications, and addenda numbered to \_\_\_\_\_\_ inclusive for the Base Bid of:

#### **DESCRIPTION**

**BASE BID** 

•	mount in words):		dollars
and	cents		
Numerical a	mount (\$		)
(Not in	cluding Sales Tax)		
ENCH EXCA	VATION SAFETY PROVISIONS		
costs for tre trench safet	nount contains any Work which requires nch safety shall be included in the Base y systems in compliance with Chapter 3 must include a lump sum dollar amount nsive.	Bid and indicated abo 9.04 RCW. 49.17 RC\	ove for adequate N and WAC 296-1
Total Amour	nt: (in words)		
		dollars and	cents
	mount (\$		
(Not in	cluding Sales Tax)		
TERNATES			
Alternate B	id No. 01: Add Platform 508.		
Total Bid: (a	mount in words):		
		dollars and	cents
	mount (\$ cluding Sales Tax)		)
Alternate B	id No. 02: Deductive - Delete Exterior F	Roof Canopies.	
Total Bid: (a	mount in words):	·	
`	,	dollars and	cents
Numerical a	mount (\$		
(Not in	cluding Sales Tax)		
Alternate B	id No. 03: Deductive - Delete Library Ex	xterior Roof Canopy.	
Total Bid: (a	mount in words):		
		dollars and	cents
	mount (\$ cluding Sales Tax)		)
Alternate B	id No. 04: Additive - Reseal Paving and	d Repaint Pavement S	tripina.
	mount in words):	,	. 5
( ~	*		
		dollars and	cents

Alternate Bid No. 05: Additive - Add Play Area Wood Chips.

Total Bid (amount in words):		
	dollars and	cents
	<b>)</b>	
(Not including Sales Tax)		
Alternate Bid No. 06: Deductive - D	Pelete Athletic Field Irrigation System.	
Total Bid: (amount in words):		
, ,	dollars and	cents
	)	
(Not including Sales Tax)	,	
Alternate Bid No. 07: Deductive - F	Replace Storefront with Vinyl Window Assembl	ies.
Total Bid: (amount in words):		
	dollars and	cents
	)	
(Not including Sales Tax)	,	
Alternate Bid No. 08: Deductive - D	Delete Interior Storefronts.	
Total Bid: (amount in words):		
,	dollars and	cents
	)	
(Not including Sales Tax)	,	
Alternate Bid No. 09: Deductive - D	Delete Casework various locations.	
Total Bid: (amount in words):		
,	dollars and	cents
	)	
(Not including Sales Tax)	,	
Alternate Bid No. 10: Deductive - D	Delete Benches and Casework Workcounters.	
Total Bid: (amount in words):		
· · · · · · · · · · · · · · · · · · ·	dollars and	cents
	)	
(Not including Sales Tax)	,	
Alternate Bid No. 11: Deductive - D	Delete Library Casework portions.	
Total Bid: (amount in words):	•	
,	dollars and	cents
	)	
(Not including Sales Tax)	,	

Alternate Bid No. 12: Deductive - Delete Science Casework portions.

Total Bid: (amount in words):		
	dollars and	_ cer
Numerical amount (\$	)	
(Not including Sales Tax)		
Alternate Bid No. 13: Deductive - Delete New Loc	kers.	
Total Bid: (amount in words):		
	dollars and	се
Numerical amount (\$	)	_
(Not including Sales Tax)	,	
Alternate Bid No. 14: Additive - Add Acoustic Wall	l Panels.	
Total Bid: (amount in words):		
,	dollars and	се
Numerical amount (\$		
(Not including Sales Tax)	/	
Alternate Bid No. 15: Additive - Add Multi-Purpose	e 502 Resilient Athletic Flooring.	
Total Bid: (amount in words):		
,	dollars and	се
and the second s	)	-
(Not including Sales Tax)	,	
Alternate Bid No. 16: Deductive - Delete Column I	Bases, Bench and Resin Panel G	lazi
Total Bid: (amount in words):	,	
,	dollars and	ce
Numerical amount (\$		_ 00
(Not including Sales Tax)	/	
T PRICES		
Unit Price No. 01: Replacement of damaged existi	ing wood framing (per board foot)	
	dollars and	_ce
Numerical amount (\$	)	
(Not including Sales Tax)		
Unit Price No. 02: Replacement of damaged existi	ing plywood roof sheathing (per p	ane
	dollars and	ce
Numerical amount (\$		
(Not including Sales Tax)	<del></del> -	
Unit Price No. 03: Replacement of damaged existi	ing T&G roof decking (per board f	oot
	dollars and	се

Numerical amount (\$		)
(Not including Sales Tax)		
Unit Price No. 04: Replacement of damaged	exterior concrete slab (per	square foot).
	dollars and	cents
Numerical amount (\$		)
(Not including Sales Tax)		
Unit Price No. 05: Patch and Repair of dama	ged interior concrete slab (	per square foot).
	dollars and	cents
Numerical amount (\$		)
(Not including Sales Tax)		<i>,</i>
Unit Price No. 06: Removal and abatement of	f existing black mastic (per	square foot).
	dollars and	cents
Numerical amount (\$		)
(Not including Sales Tax)		

#### **IDENTIFICATION OF SELECTED SUBCONTRACTORS:**

The Bidder shall name the Subcontractor with whom the Bidder, if awarded the Contract, will subcontract directly (not Subsubcontractors) for performance of the following Work:

Plumbing as described in RCW 18.106.

Heating, Ventilation and Air Conditioning.

Electrical as described in RCW 19.28.

Any other categories of Work listed below.

If the Bidder intends to self-perform any of the categories of Work, it must name itself for each such category of Work. The Bidder shall not list more than one entity for a particular category of Work identified, unless a Subcontractor varies with an Alternate Bid, in which case the Bidder shall identify the Subcontractor to be used for the Alternate in the specified column for the affected portion of the Work. If no entry is made in the "Subcontractor (if Alternate is Accepted") column, it will be presumed that the Subcontractor will not change with any Alternates.

## IF A SUBCONTRACTOR CATEGORY WILL NOT BE USED ON THIS PROJECT, EITHER WRITE "NONE" OR LEAVE BLANK

In accordance with RCW 39.30.060, failure of a Bidder to submit as part of the Bid the names of such proposed heating, ventilation and air conditioning, plumbing, or electrical Subcontractors or to name itself to perform such Work or the naming of two or more Subcontractors to perform the same Work shall render the Bidder's Bid nonresponsive and, therefore, void.

Sample table below. Prepare project appropriate table with adequate number of columns to address Subcontractor's listed and if Subcontractor's listed change as affected by Alternates.

Type of Work	Plumbing as described in RCW 18.106	Heating, Ventilating and Air Conditioning	Electrical as described in RCW 19.28
Subcontractor			
Subcontractor			
(Alternate No)			
Subcontractor			
(Alternate No)			
Subcontractor			
(Alternate No)			

The undersigned agrees to hold this proposal open for forty-five (45) days following the opening of Bids and to execute the Agreement within seven (10) days if the Contract is awarded on the basis thereof.

The undersigned agrees, if awarded the Contract to substantially complete the Work per the schedule noted in the Administrative Requirements Section.

The undersigned further agrees that if awarded the Contract, not less than 10 percent of the Work (excluding General Conditions) shall be accomplished with the Bidder's own Work force.

The undersigned further agrees, if awarded the Contract, to execute and deliver to the owner not later than the date of execution of the Contract satisfactory performance and payment bonds in an amount equal to 100 percent of the total Contract sum (Base Bid plus accepted alternates, plus Washington State sales tax), and Certificate of Insurance.

Bid security in the form of a Bid bond, certified bank check, or cashier's check, in the amount not less than 5 percent of the base Bid, excluding applicable Washington State taxes, and all made payable to the owner, is enclosed. The undersigned agrees that such Bid security, accompanying this proposal and left in escrow with the owner, shall be forfeited and the amount stated herein made payable to the owner if the undersigned fails to execute and deliver the specified Agreement form and performance and payment bonds within ten (10) calendar days after being notified in writing by the owner of their selection as successful Bidder. The Bid security will be returned to the undersigned if this proposal is not accepted within forty-five (45) calendar days from above-indicated Bid opening date. If a Contract is awarded to any other Bidder, such Bid security will be returned to the undersigned within three (3) calendar days after Contract has been signed.

The requirements of Washington State RCW Chapter 39.12 Prevailing Wages are included as a part of this Bid and the undersigned agrees to comply with provisions thereof.

The owner reserves the right to reject any or all Bids and waive all informalities.

#### MINORITY AND WOMEN'S BUSINESS ENTERPRISE UTILIZATION:

The School District encourages the participation of Minority Owned and Women Owned Business Enterprises in this Invitation to Bid.

The undersigned hereby verifies under penalty of perjury, in accordance with RCW 9A.72.085, that Bidder is in compliance with the responsible Bidder criteria requirement of subsection (1)(g)

of RCW 39.04.350. Specifically, within the three-year period immediately preceding the date of the Bid solicitation for this Project, Bidder has not been determined by a final and binding citation and notice of assessment issued by the department of labor and industries or through a civil judgment entered by a court of limited or general jurisdiction that Bidder has willfully violated, as defined in RCW 49.48.082, any provision of chapter 49.46, 49.48, or 49.52 RCW. The undersigned certifies (or declares) under penalty of perjury under the laws of the State of Washington that the foregoing is true and correct.

NAME OF FIRM:	
Ву:	
	_ (Signature)
	(Title)
	_ (Name (Print/Type)
Date:	<del> </del>
(Physical Location (City) of pe time of signing)	rson signing this form at
ADDRESS:	
	_ (Address Line 1)
	_ (Address Line 2)
	(Telephone)
	_ (Fax Number)
	(Email)
MEMBERS OF FIRM IF PARTNERSHIP OR JOINT VENTURE	:
	Name (print/type)
	N. I
	_ " '. '
If firm is a corporation, state in which incorporated:	
State of Washington Contractor's registration number:	
State of Washington Contractor's license number:	
Federal Tax Identification Number (TIN):	

#### **LIST OF STRUCTURAL STEEL AND REBAR INSTALLERS:**

List of Structural Steel and Rebar Installers due by **2:00 p.m. Friday, August 29, 2025**. <u>Submit to District Office</u>.

TO:
Board of Directors: Pe Ell School District No.
301519 N. 2nd Street
Pe Ell, WA 98572
STRUCTURAL STEEL INSTALLER:
REBAR INSTALLER:
If different from the list above, the subcontractors we propose to use if an Alternate Bid is accepted, is described below. (RCW 39.30.060 requires, in part, that the bidder shall not list more than one subcontractor for each category of work identified, unless subcontractors vary with bid alternates, in which case the bidder must indicate which subcontractor will be used for which alternate.)
Descibe any change to list if alternates are accepted:
Signature:
Contractor's Name:

**END OF SECTION**